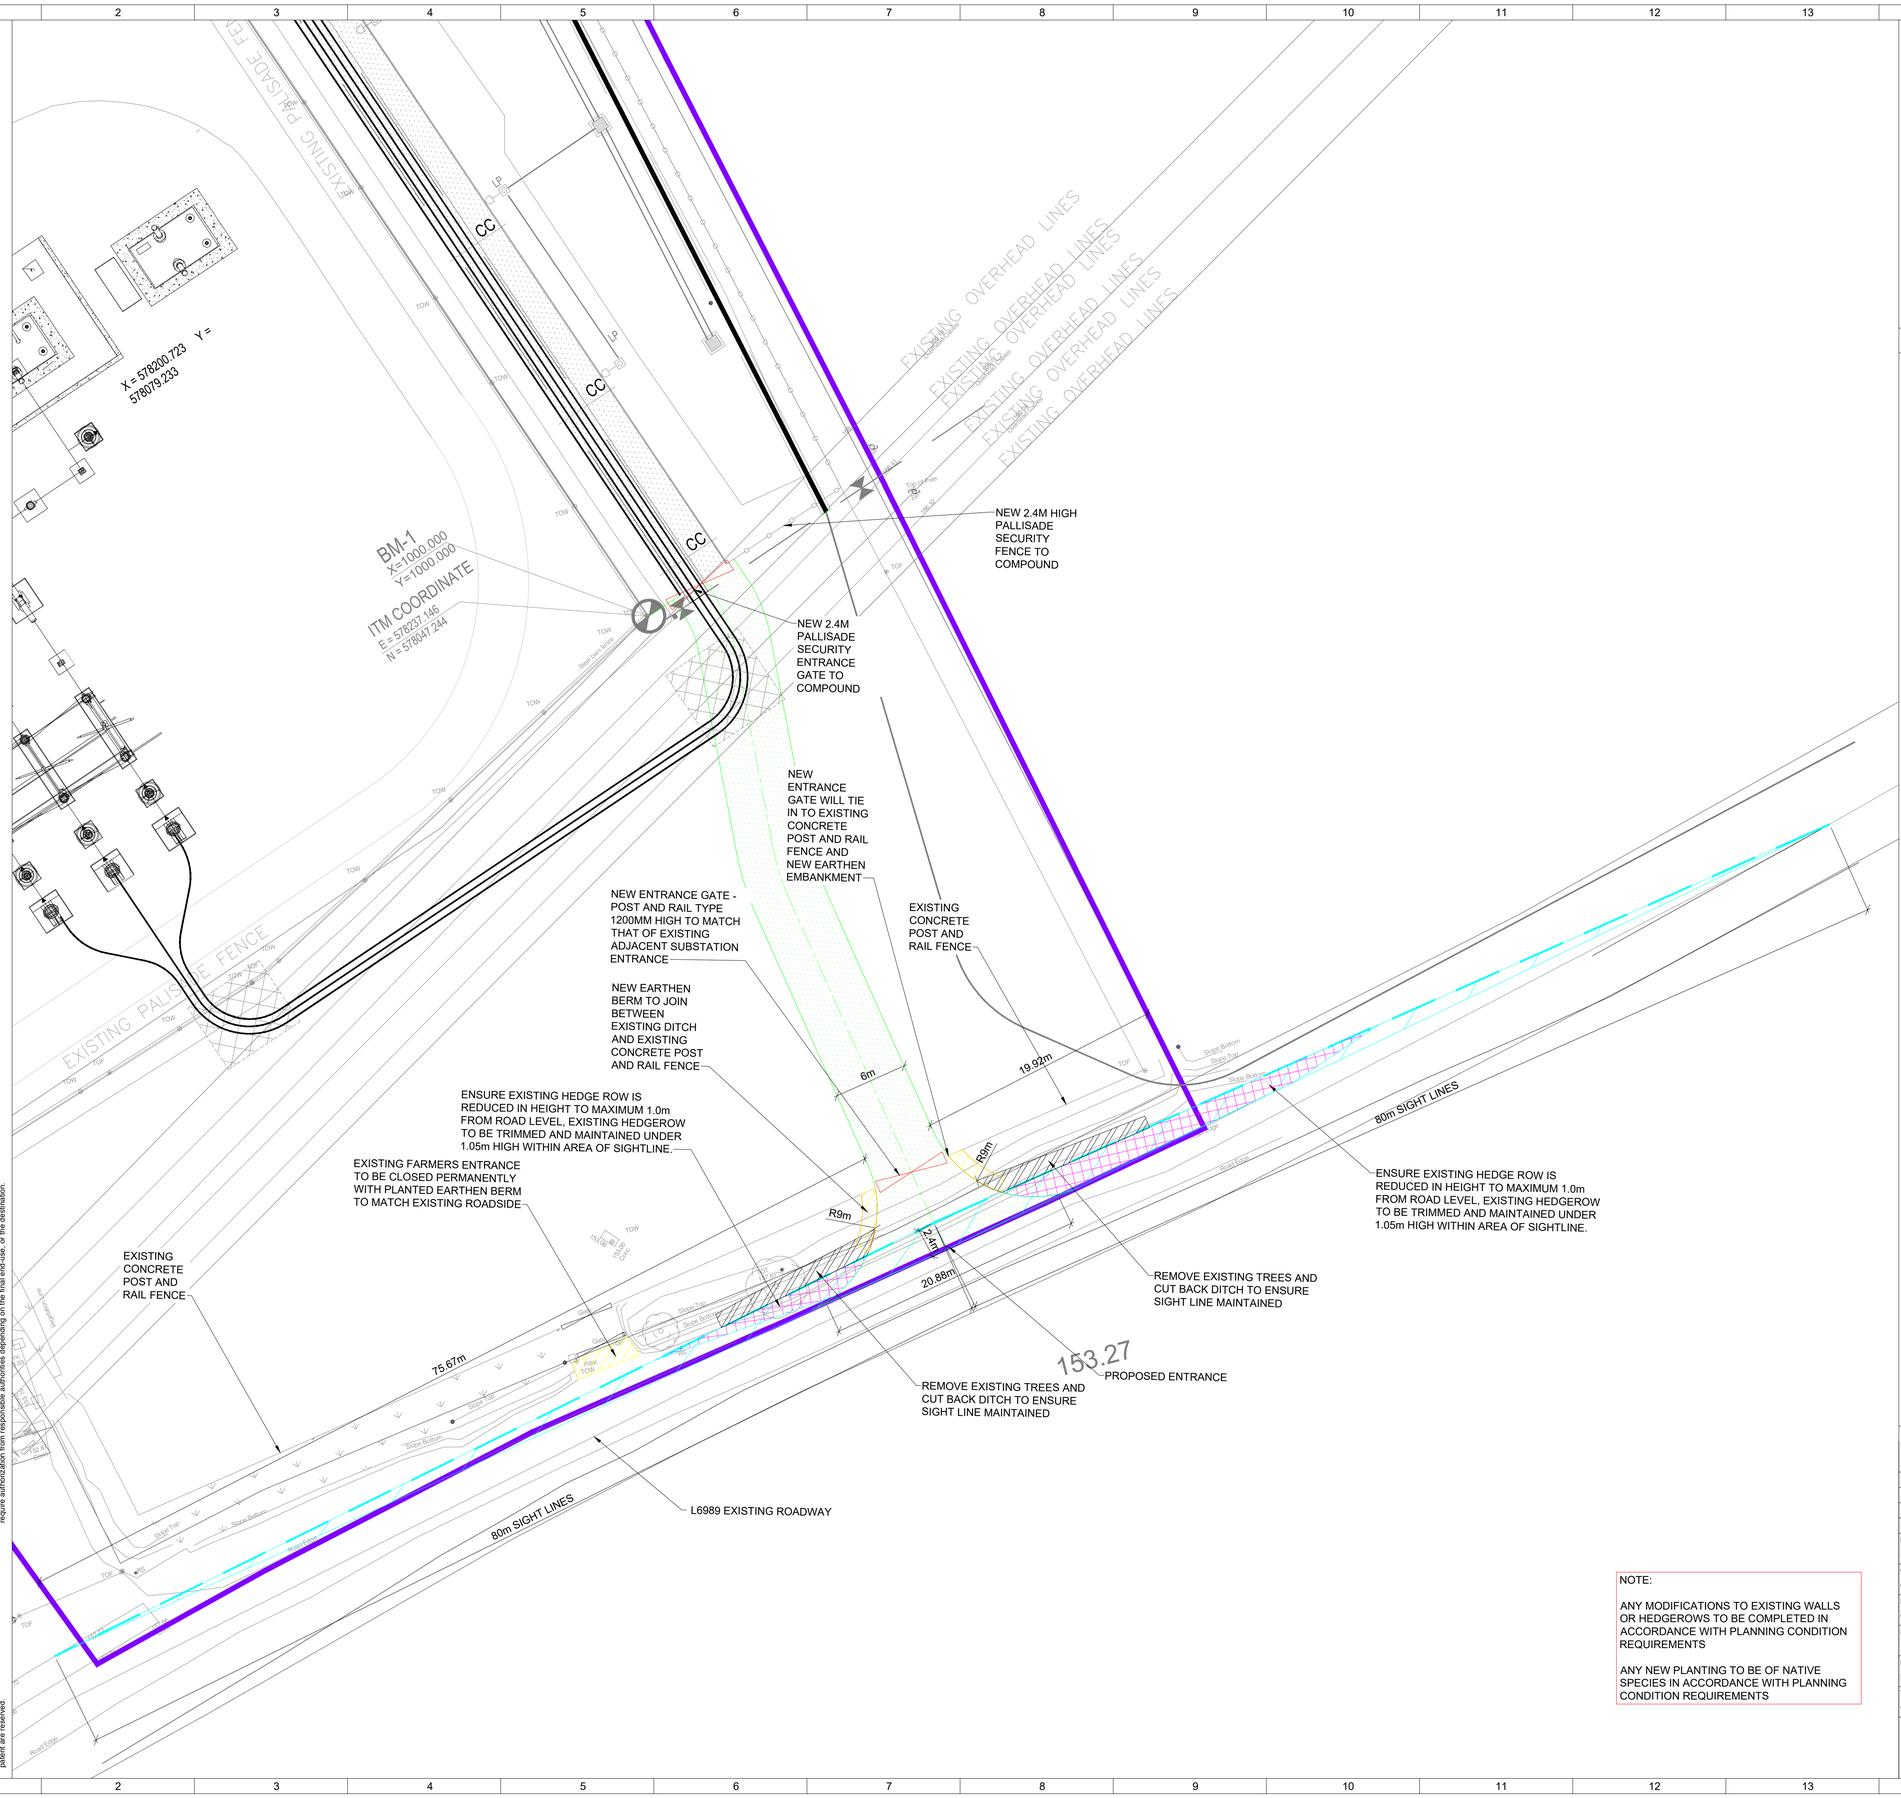

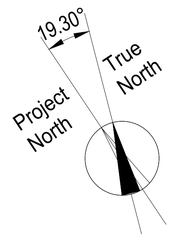

LEGEND:

- VISIBILITY SPLAY TO BE MAINTAINED
- VEGETATION REMOVAL
- NEW EARTHEN BERM
- BOUNDARY
- PROPOSED AMENDMENTS
- SECURITY PALISADE FENCE
- PROPERTY BOUNDARY FENCE
- EXISTING EQUIPMENT
- EQUIPMENT APPROVED BY ABP UNDER PI. REF. VA04.312298 (PCI0003) AND SUBSEQUENT APPROVED 146b AMMENDMENTS
- GATE- REFER TO DRAWING NOTE FOR TYPE

NOTE:

ANY MODIFICATIONS TO EXISTING WALLS OR HEDGEROWS TO BE COMPLETED IN ACCORDANCE WITH PLANNING CONDITION REQUIREMENTS

ANY NEW PLANTING TO BE OF NATIVE SPECIES IN ACCORDANCE WITH PLANNING CONDITION REQUIREMENTS

SECTION DESTINATION CONTROL STATEMENT:
These items are controlled by the U.S. Government (when labeled with "ECCN" unequal "N") and authorized for export only to the country of ultimate destination for use by the ultimate consignee or end-user(s) herein identified. They may not be resold, transferred, or otherwise disposed of, to any other country or to any person within the country of ultimate consignee or end-user(s) without prior written approval of Siemens Energy. Diversion contrary to U.S. law prohibited. Items labeled with "AL" unequal "N" are subject to European / national export authorization. Items without label / with label "AL:N" / "ECCN:N" or label"AL:9X999" / "ECCN:9X999" may require authorization from responsible authorities depending on the final end-use, or the destination.

Restricted © Siemens Energy, 2023
Transmittal, reproduction, dissemination and/or editing of this document as well as utilization of its contents and communication thereof to others without express authorization are prohibited. Offenders will be held liable for payment of damages. All rights created by patent grant or registration of a utility model or design patent are reserved.

IFI		IFR = Issued for review IFI = Issued for information IFC = Issued for construction	IFIM = Issued for implementation (Design input) IFM = Issued for manufacture AB = As built (Documentation)	DMS Identifier E4A000001207198
01	13.10.23	ISSUED FOR INFORMATION		P.V.
Rev.	Date	Remark		Created By

Project ID	Doc. Key	Aspect	Customer Document Number	Plant Type / Voltage
P-020549	T	C		HVDC PLUS SYMMETRICAL MONOPOLE

Customer: CIDAC

Voltage: ± 320kV DC, 400kV Ac, 50Hz, 700MW

Project: Celtic Interconnector

Location(s): Knockraha Cable Sealing End Compound

Scale: 1:250

Export Control Classification: ECCN: N AL: N

Document Type: LOCATION PLAN

Document Designation: P-020549_TC_12240.U#CE15&BLD010/002

Title, Supplementary Title: CELTIC INTERCONNECTOR KNOCKAHA SUBSTATION SECTION 146B JUNCTION LAYOUT DRAWING

MWP ENGINEERING AND ENVIRONMENTAL CONSULTANTS

MWP Job No. 23862

Page Size A1

Page 1